

Anchor to be installed no more than 2 1/2" above grade

Corner bolts shall be used to secure post to sleeve.

2-1/2" X 2-1/2"
X 12 GA. @ 12"
LONG SLEEVE

FILLET WELD
ALL AROUND


2-1/4" X 2-1/4"
X 12 GA. @ 30"
LONG STEEL TUBE

NOTE:

POST ANCHOR SHALL BE 30"
ANCHOR-MATE W/12" SLEEVE,
ULTIMATE HIGHWAY PRODUCTS,
INC. MODEL 9UM 225/30250/12.
OR APPROVED EQUAL. COMPANY
ADDRESS:
P.O. BOX 7
STANTON, CA 90680

PENETRATOR
END CUT

EXPLODED VIEW

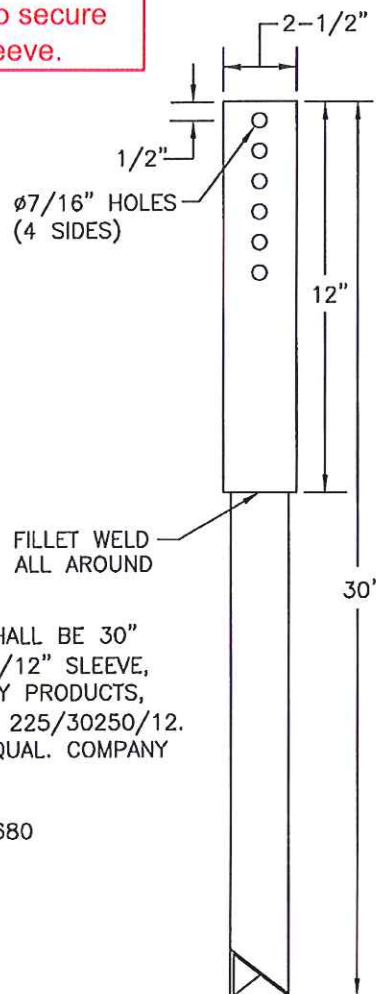

SIDE VIEW



CITY OF CLOVIS

DWG NO.
ST-15A

STREET SIGN POST ANCHOR

REF.:
STD. SPECIFICATIONS
SECTION 84

APPROVED BY:

NO.

REVISED

BY

APPROVALS

SCALE: NTS

CITY ENGINEER

05-20-09

BGJ

CM

DRU

PUD

DRAWN BY: JA

DATE:

01-14-11

BGJ

SHEET 1 OF 1