


Remove reference to Note 6

Add "colored stamped" to concrete description.

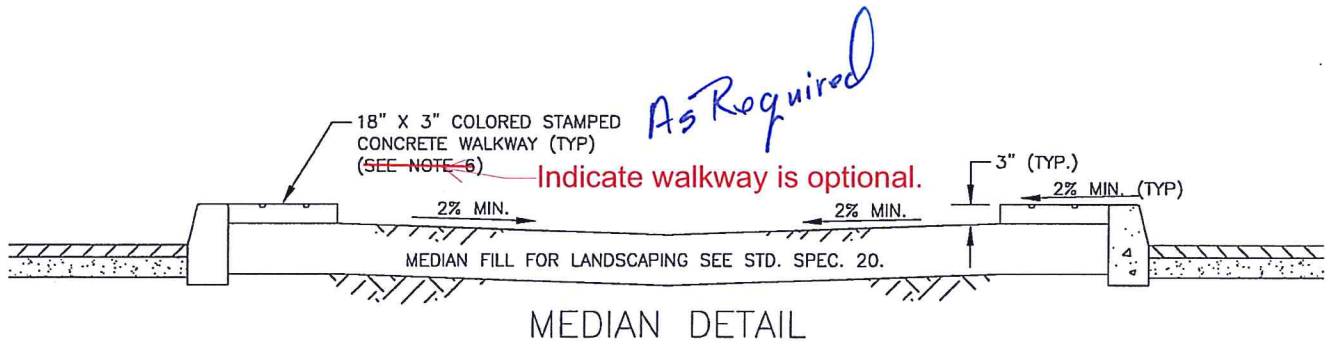

As Required

Indicate walkway is optional.

# NOTES:

1. FORMED CURB SHALL BE CLASS 3 CONCRETE; EXTRUDED CURBS SHALL BE CLASS 2.
2. CURBS SHALL BE BROOM FINISH.
3. COMPACT MEDIAN FILL MATERIAL TO 90% UNDER SURFACES TO BE PAVED.
4. MEDIAN FILL MATERIAL MAY VARY DEPENDING ON LANDSCAPING REQUIREMENTS.
5. FILL INSIDE MEDIAN BEFORE PLACING AND/OR COMPACTING MATERIAL IN THE TRAVELED WAY.
6. FOR DIRT-ONLY MEDIAN (NO LANDSCAPING IN PROJECT) OMIT STAMPED CONCRETE WALKWAY.
7. ALL COLORED STAMPED CONCRETE SHALL BE SEALED WITH TWO COATS OF "CLEAR SEAL 400", OR APPROVED EQUAL.

Clear Seal 400 is not VOC compliant in the Valley. The Clear Seal 100 has a lower VOC content and is compliant.

Remove Note 6

100



## CITY OF CLOVIS MEDIAN ISLAND CURB DETAILS (NEW AC PAVEMENT)

DWG NO.

ST-25

REF.:  
STD. SPECIFICATIONS

SCALE: NTS

DRAWN BY: JA

SHEET 1 OF 1

APPROVED BY:

CITY ENGINEER

DATE:

NO.

REVISED

BY

APPROVALS

3-26-12

05-29-12

09-28-12

PAA

PAA

PAA

CM

DRU

PUD

APPROVALS