


Reorient entire drawing

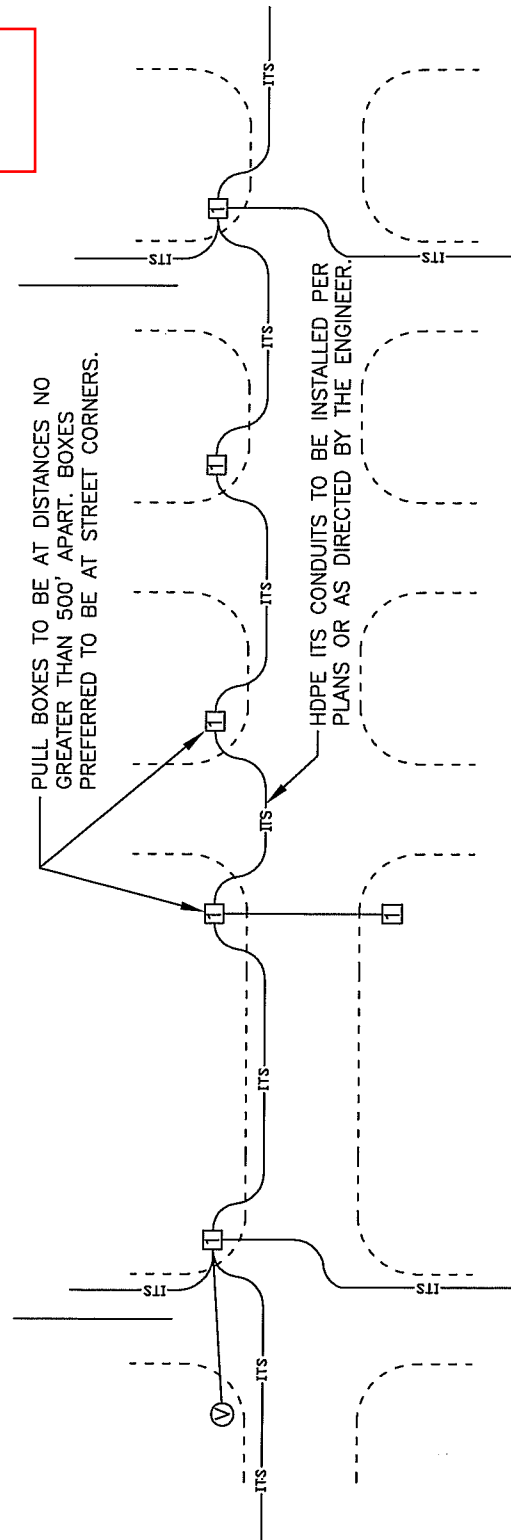

NOTE:

ALL UNDERGROUND CONDUIT SHALL HAVE A TRACER WIRE AFFIXED TO THE OUTSIDE OF THE CONDUIT. THE TRACER WIRE SHALL BE NO. 10 STRANDED COPPER, WHITE INSULATION.

LEGEND

□ ITS VAULT TO BE N48T OR PER PLANS.

⊙ IP DEVICE PER CURRENT CITY OF CLOVIS STANDARD.



# CITY OF CLOVIS

## TYPICAL ITS CORRIDOR LAYOUT

DWG NO.

ITS-1

REF. STD. SPECIFICATIONS:  
SECTION 82 & 86

APPROVED BY:

CITY ENGINEER

DATE:

10/26/11

NO.

REVISED

BY

APPROVALS

SCALE: NTS

08-03-11

BGJ

CM

DRU

PUB

OTHER

OTHER

OTHER

DRAWN BY: JA

SHEET 1 OF 1